




EAST 47TH ST

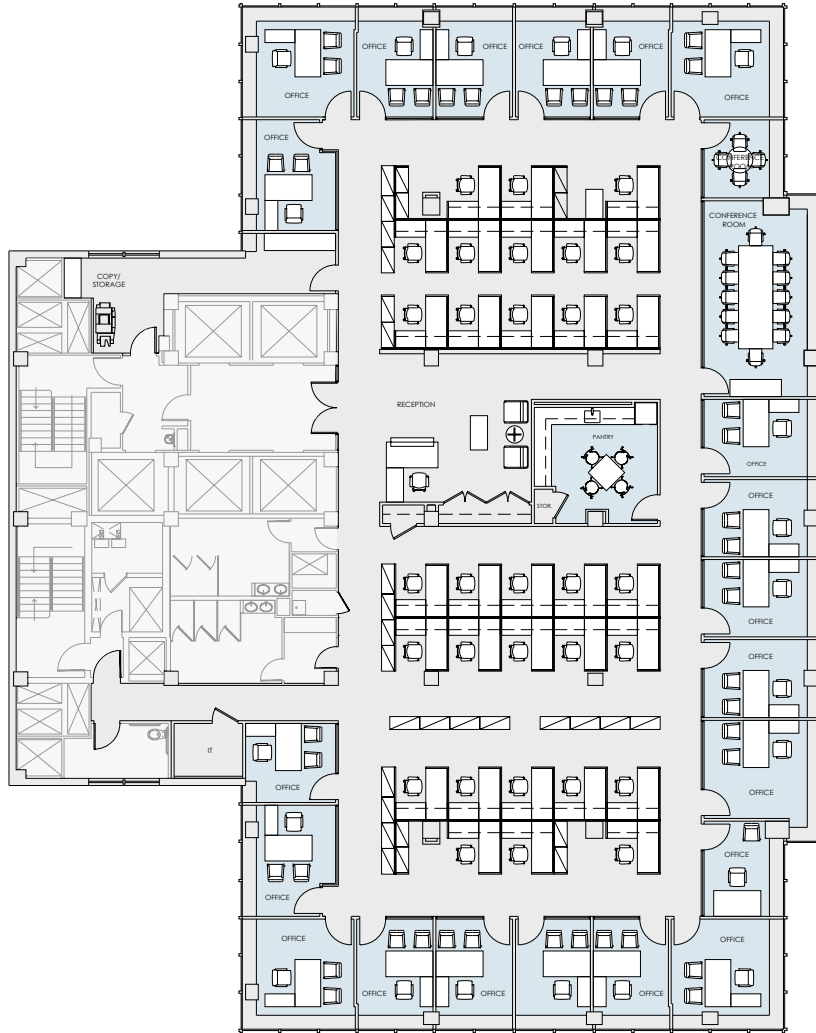

THIRD AVE

11,779 RSF

ENTIRE 28TH FLOOR AS-BUILT PLAN

Floor Key:	
Offices	21
Workstations	31
Conference Rooms	3
Reception	1
Pantry	1
Total Personnel	56

EAST 46TH ST



[Click here for more information](#)

