




EAST 47TH ST

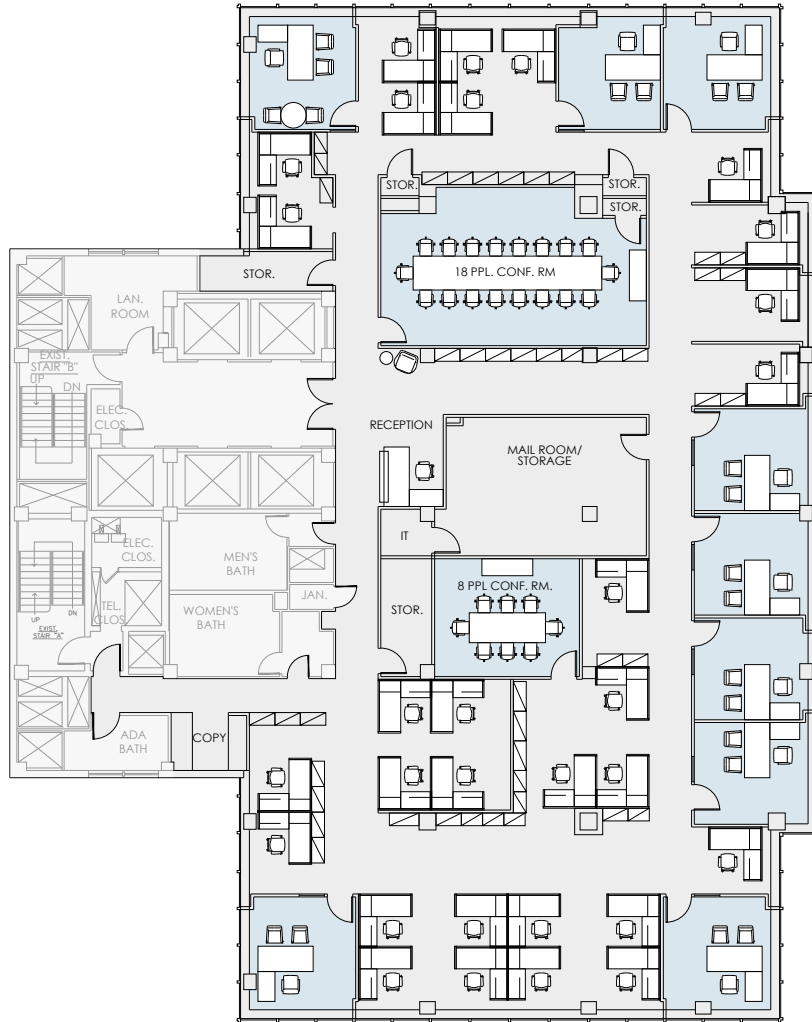

EAST 46TH ST

THIRD AVE

11,779 RSF

ENTIRE 32ND FLOOR AS-BUILT PLAN

Floor Key:	
Offices	9
Workstations	30
Conference Rooms (18)	7
Conference Rooms (8)	1
Reception	1
Total Personnel	40



[Click here for more information](#)

