




EAST 47TH ST

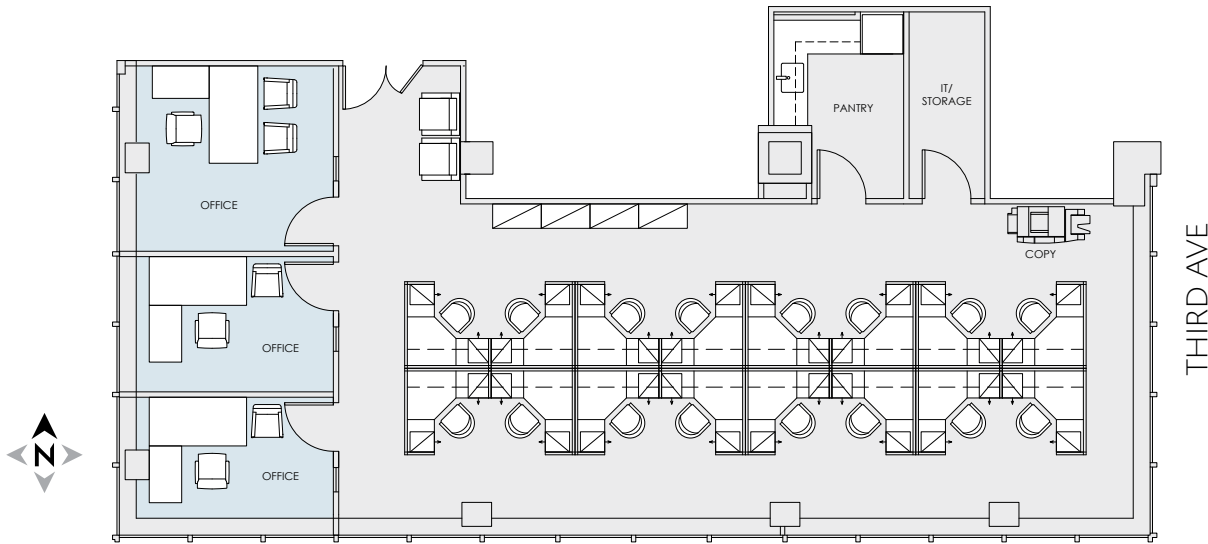

EAST 46TH ST

THIRD AVE

2,782 RSF

PARTIAL 23RD FLOOR AS-BUILT PLAN

Floor Key:	
Offices	3
Workstations	16
Pantry	1
Total Personnel	19

[Click here for more information](#)





EAST 47TH ST



2,782 RSF
PARTIAL 23RD FLOOR TEST FIT

Floor Key:	
Offices	2
Workstations	8
Pantry	1
Conf. Room (8)	1
Conf. Room (6)	1
Total Personnel	10

[Click here for more information](#)

