
FL. 11 AS-BUILT **35,459**RSF

Workstation	83
Offices	42
Conference Rooms	5
Cafe/Pantry	1
Total Personnel	125
<image/>	

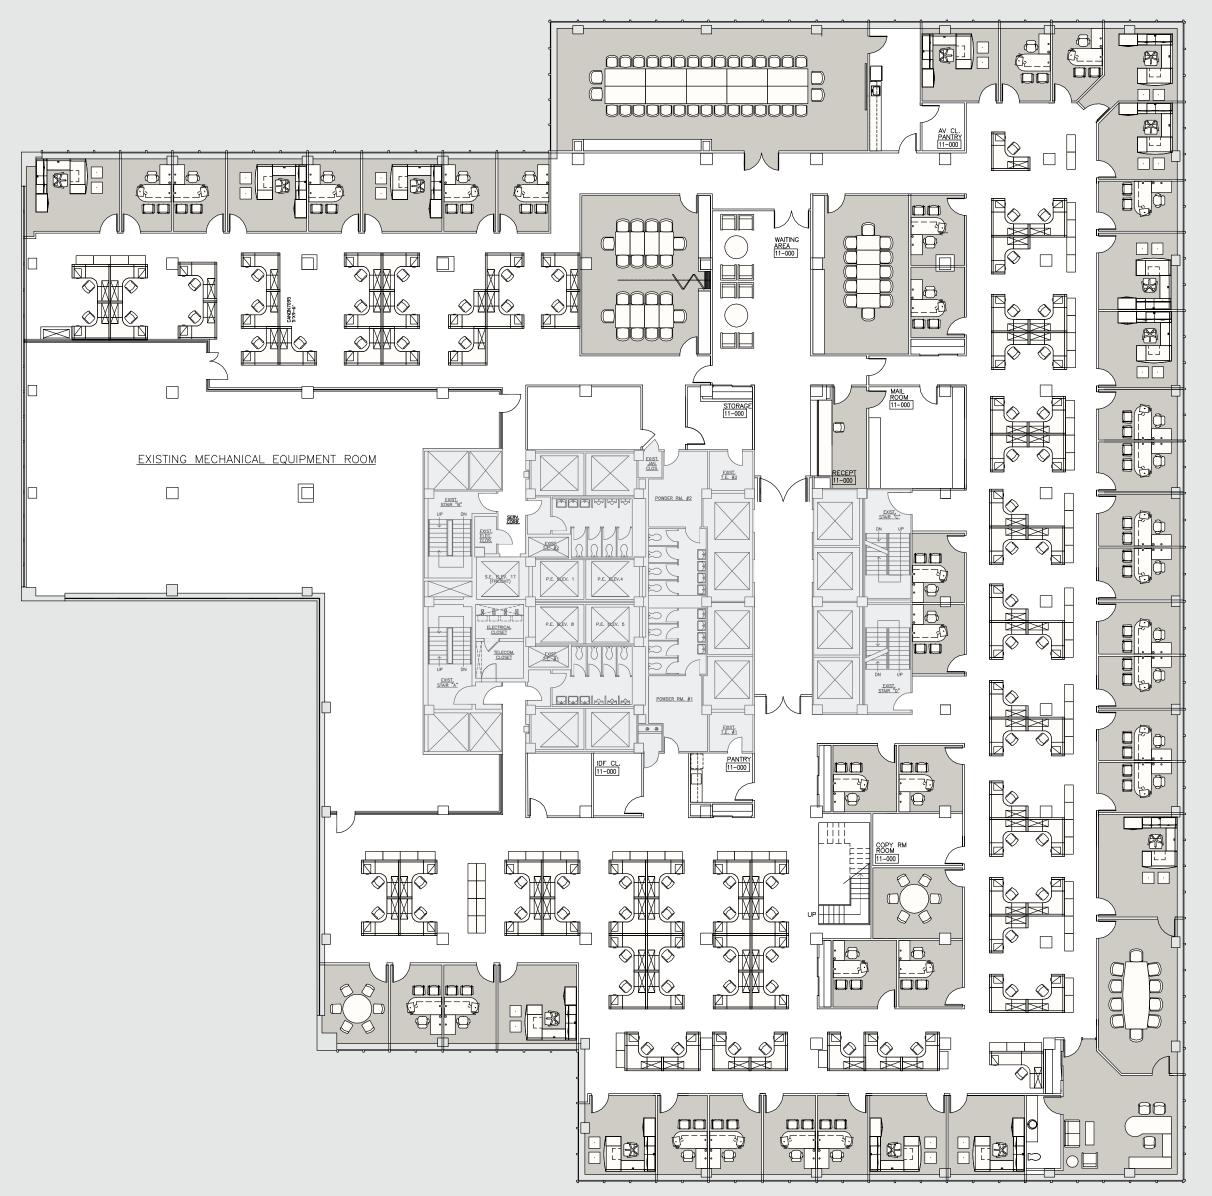

 \longrightarrow EAST 46TH ST

 $\longleftarrow \mathsf{EAST} \mathsf{ 47TH} \mathsf{ST}$