


ENTIRE 29TH FLOOR (EAST)
8,941 RSF | AS-BUILT

EAST 49TH STREET

FLOOR KEY

Private Office	10
Conference Room	3
Workstation	20
Reception	1
Pantry	1
Total Headcount	31

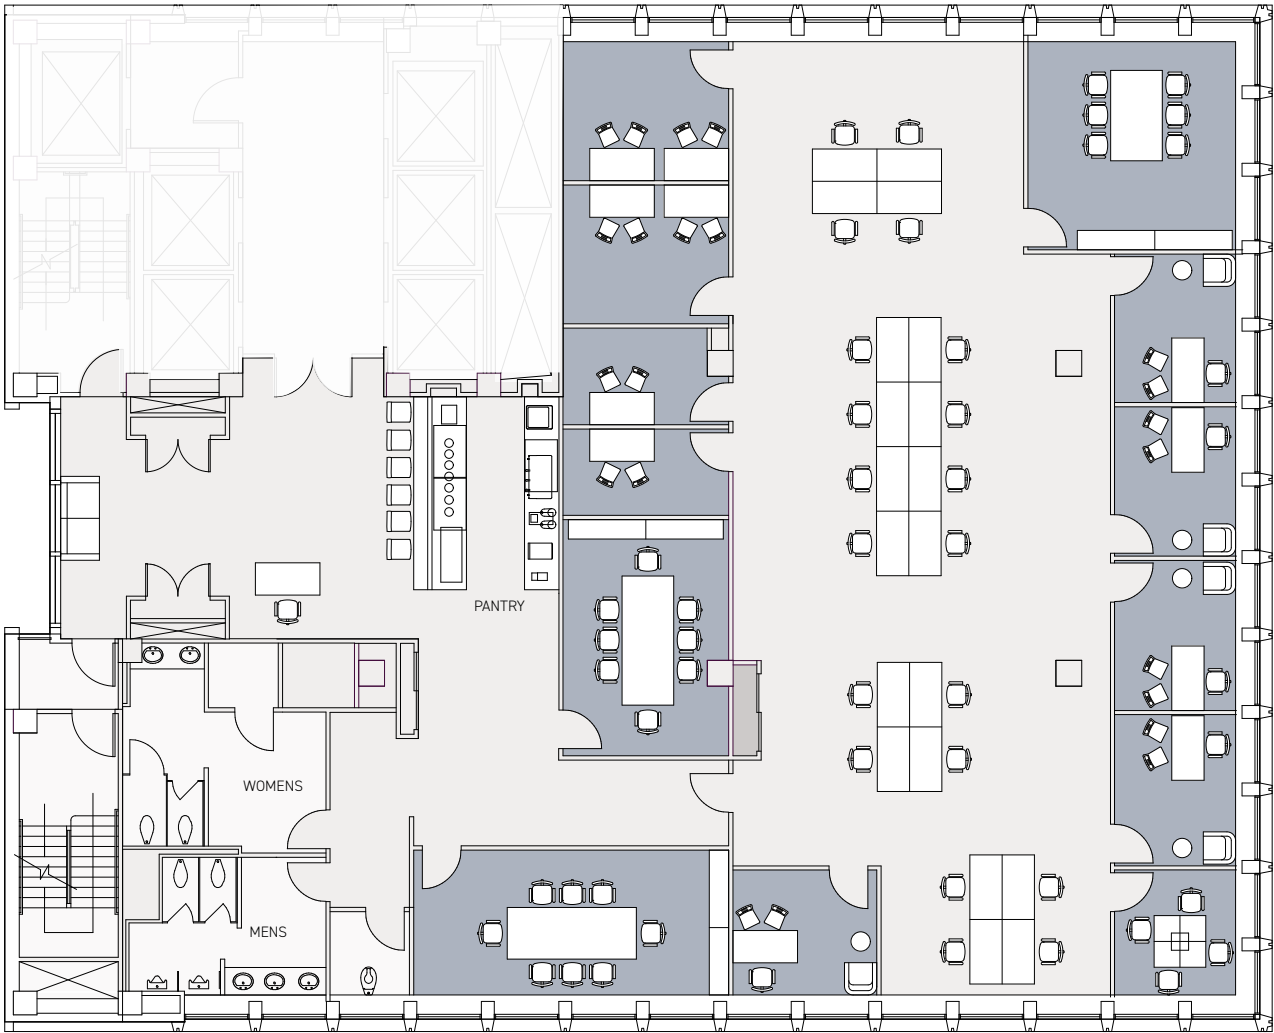

EAST 48TH STREET